

PROGRAM STUDI TEKNIK
LINGKUNGAN
FAKULTAS TEKNIK SIPIL DAN
PERENCANAAN
UNIVERSITAS ISLAM
INDONESIA
2018

NAMA MAHASISWA

TISA MAVERA SARI
14513038

NAMA DOSEN

KASAM, Dr, Ir, M.T.

JUDUL GAMBAR

LAYOUT IPAL

SKALA GAMBAR


1 : 100

KETERANGAN

AS BUILT DRAWING
RUMAH SAKIT "JIH"
YOGYAKARTA

NO. GAMBAR

08

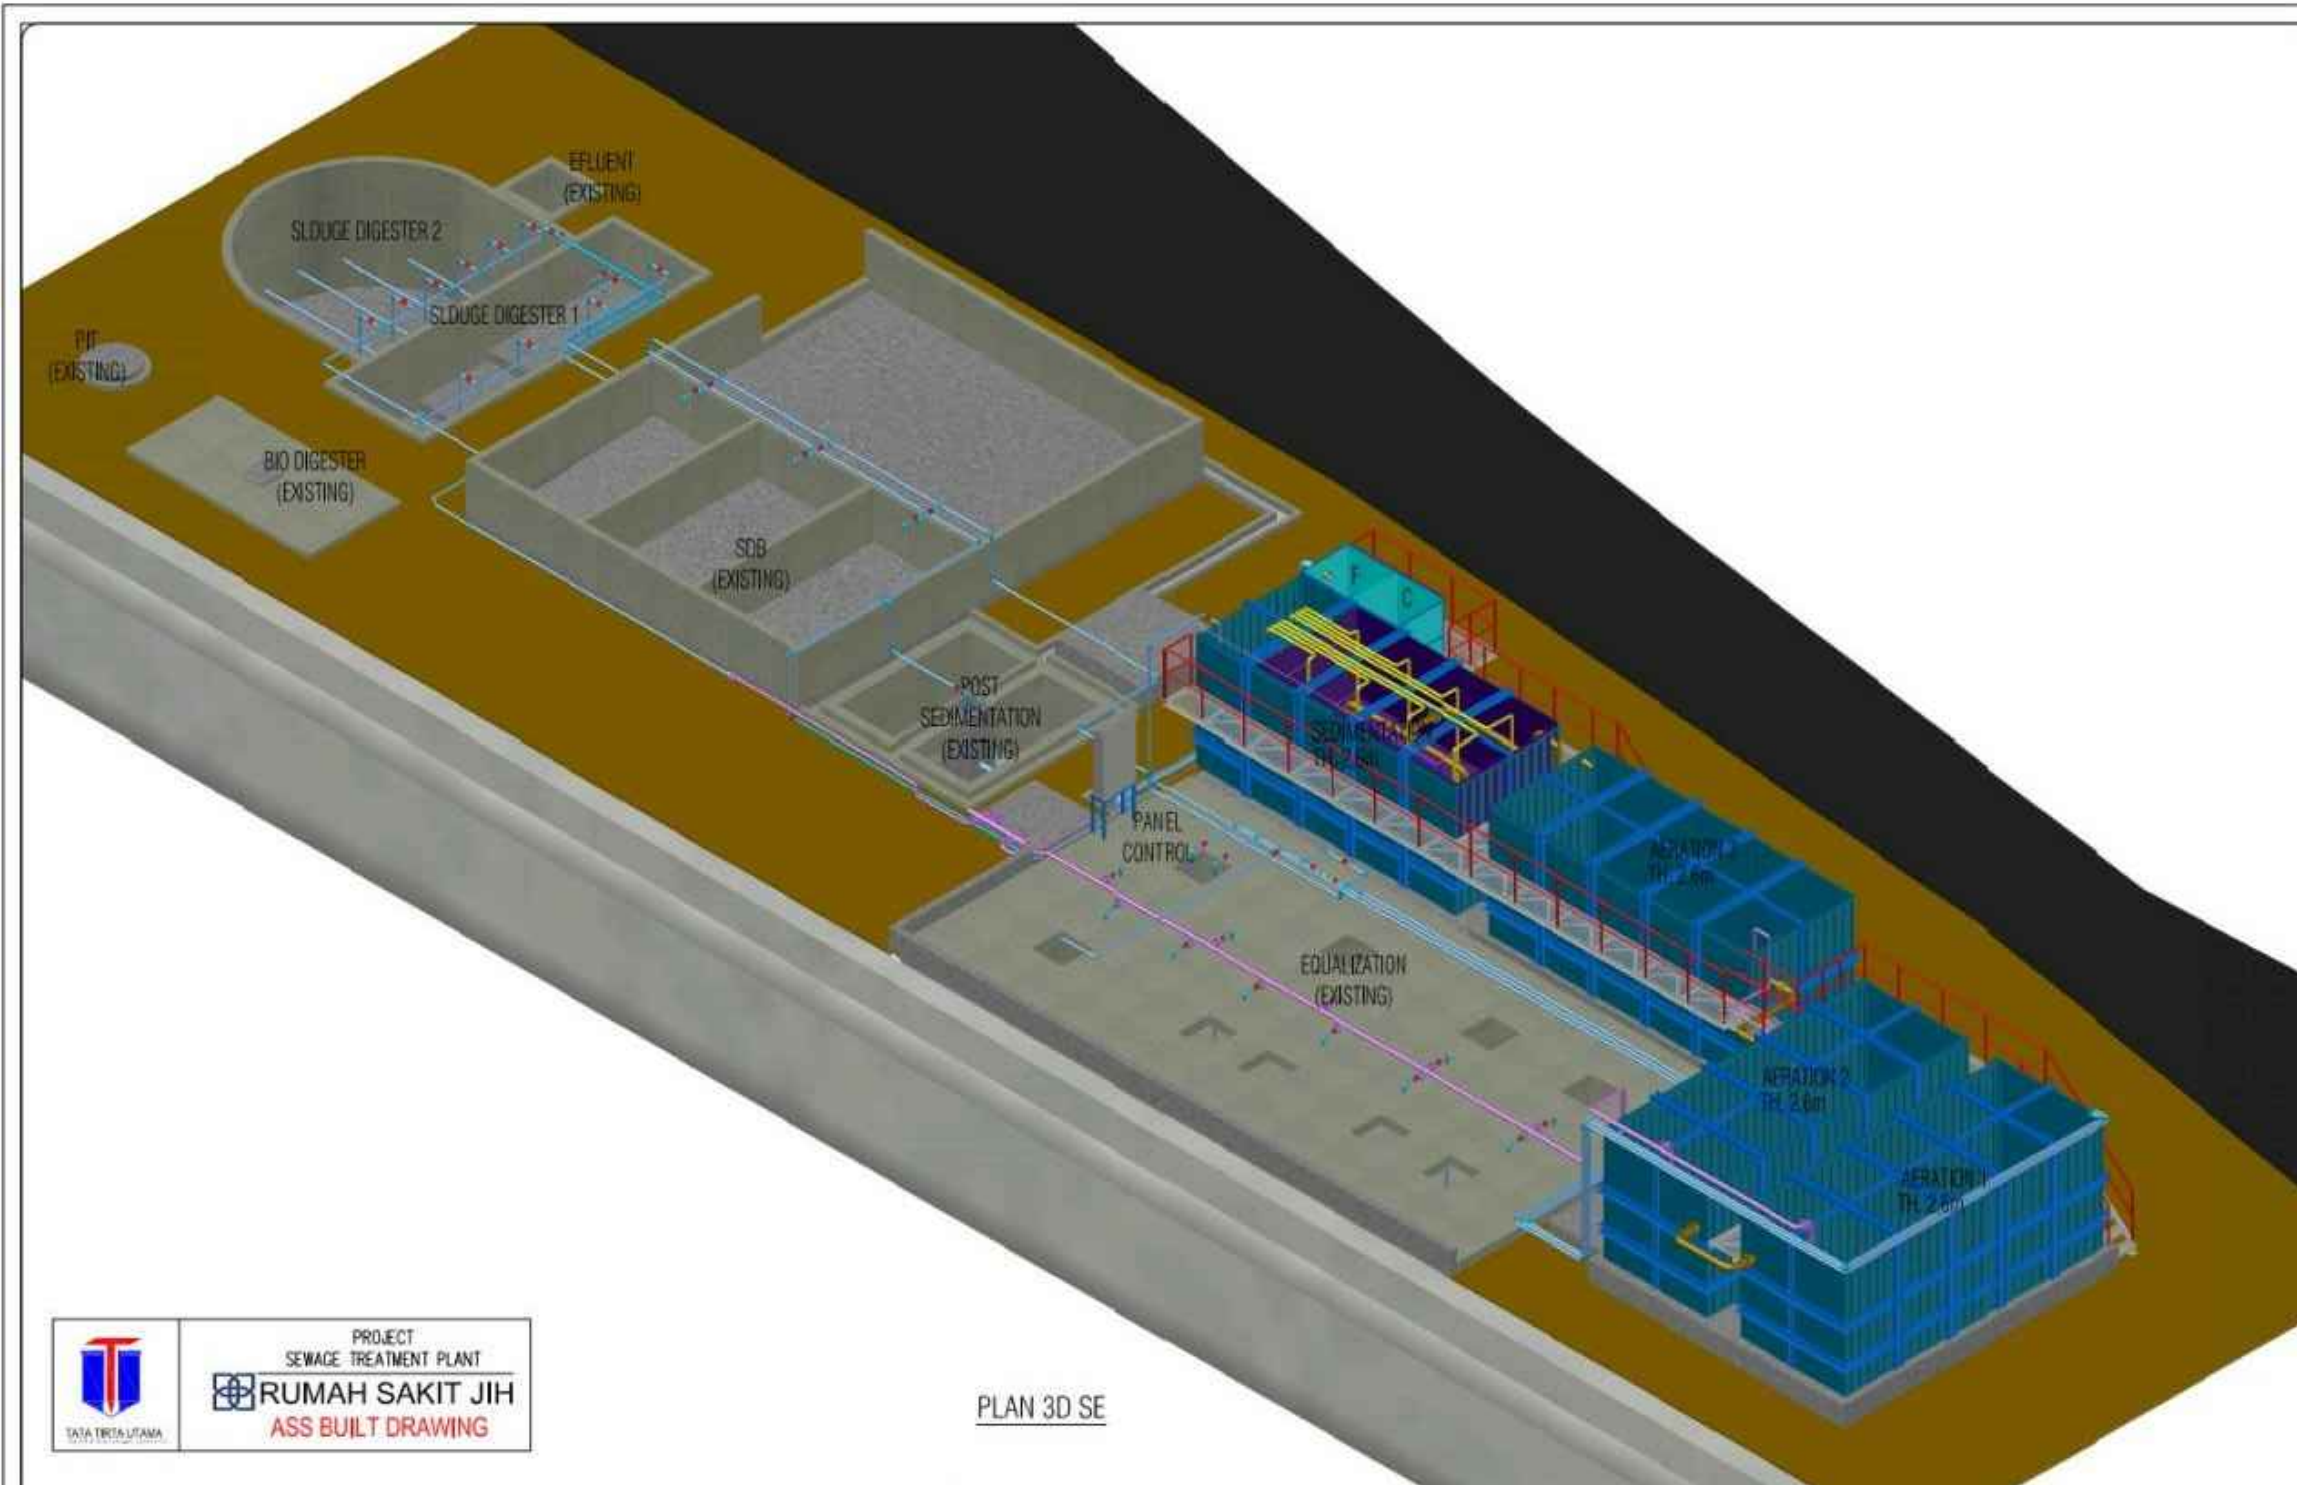


 PROJECT
SEWAGE TREATMENT PLANT

RUMAH SAKIT JIH
 ASS BUILT DRAWING

PLAN 3D SE